


**FOREST-LLEWELLYN CEMETERY'S
PROMINENT PEOPLE**

1. First burial in 1845 - A "traveler"
2. Jesse Kirk - Kirksville was named after him / buried August 31, 1846 -- Old Cemetery 62.
3. Memorial to the 26 Confederate Soldiers killed during the Battle of Kirksville - August 6, 1862 - buried in a mass grave. Forest D-12 East.
4. Corporal Harvey Dix of Company D, Third Iowa Infantry - First Civil War soldier killed in Adair County on August 16, 1961. Years later, a tombstone was placed at his grave. The Kirksville post of the Grand Army of the Republic was named for him when it was organized in 1866. - Old Cemetery 37.
5. Professor William P. Nason - First District State Normal School President / 1824-1909 / The Nason stone appears on the front cover of the last printing of the cemetery book. There is no other information available. - Sherwood 10.
6. Andrew Taylor Still, M.D., D.O. - 1828-1917 / Founder of Osteopathic Medicine - Llewellyn A 22.
7. Charles E. Still - (Son of Andrew Taylor Still) - Acting President of American School of Osteopathy / 1865-1955 / Served as Mayor 1913-1915 / Adair County Representative in the General Assembly of Missouri for 14 years / A hospital in Jefferson City bears his name - Llewellyn A 23.
8. George A. Still - President of American School of Osteopathy / 1882-1922 - Forest B 134.
9. Joseph S. Hickman - 1st District Adair County Court Judge 1898, when the courthouse was built - Llewellyn G 21.
10. Minnie Brashear - Author of 'Mark Twain, Son of Missouri' in 1934 / 1874-1963 - Llewellyn C 33.
11. William A. Clark - Normal School President / 1853-1918 - Forest B 47.
12. James A. Cooley - Circuit Judge, Missouri Supreme Court Commissioner / 1872-1948 - Forest A 43.
13. Isham B. Dodson - Civil War Major, Adair County Sheriff, State Senator / 1818-1879 - Forest B 19.
14. Andrew Ellison - Circuit Judge / 1846-1912 - Forest A 58.
15. Dr. Arthur G. Hildreth - State Senator / 1863-1941 - Forest B 83.
16. John R. Musick - Novelist / 1849-1901 - Beeman 18
17. A. Llewellyn Shepherd - Mayor /1870-71 - Forest B 89.
18. George T. Spencer - Mayor / 10/1871-4/1872 - 6 months. - Forest A 1.
19. Samuel N. Link - Mayor / 1872-73 - Forest A 76.
20. H. F. Millan - Mayor / 1873-74 - Lawyer - Forest B 36.
21. O. H. Beeman - Mayor / 1845-75 - Beeman Addition, which he is buried in - Beeman 15.
22. Francis M. Harrington - Mayor 1879-1/1881 - 1yr 8 months) Lawyer - Forest B 182.
23. Phillip M. Smith - Mayor 1881-82 - Forest B 146.
24. Samuel M. Pickler - Mayor 1882-83 - Pickler Library was named in honor of him. An alumnus, former member of the faculty, Board of Regents benefactor. He contributed \$35,000 to the erection of the new building. - Sherwood 20.
25. Dr. G. A. Goben - Mayor 1883-84; 1903-05; 1911-13 - Beeman 18.
26. Blair W. Ross - Mayor 1886-88 - Forest B 4
27. John Richey - Mayor 1888-90 - Slingerland 22.
28. Thomas J. Dockery - Mayor 1897-99 & 1901-03 - Forest A 44.
29. Thomas Jefferson Craig - Mayor 1905-07 - Llewellyn F 26.
30. George Wall Smith - Adair County's last Civil War soldier and oldest (93 years) native-born citizen. 1845 - 1939. Drummer boy who sounded the call for Union troops to enter the Civil War Battle of Shiloh and was wounded three times during the Civil War. Worked as a contractor many years and three streets - George, Wall and Smith were named for him - I lewellyn A 14

**FOREST-LLEWELLYN
CEMETERY
KIRKSVILLE, MISSOURI**

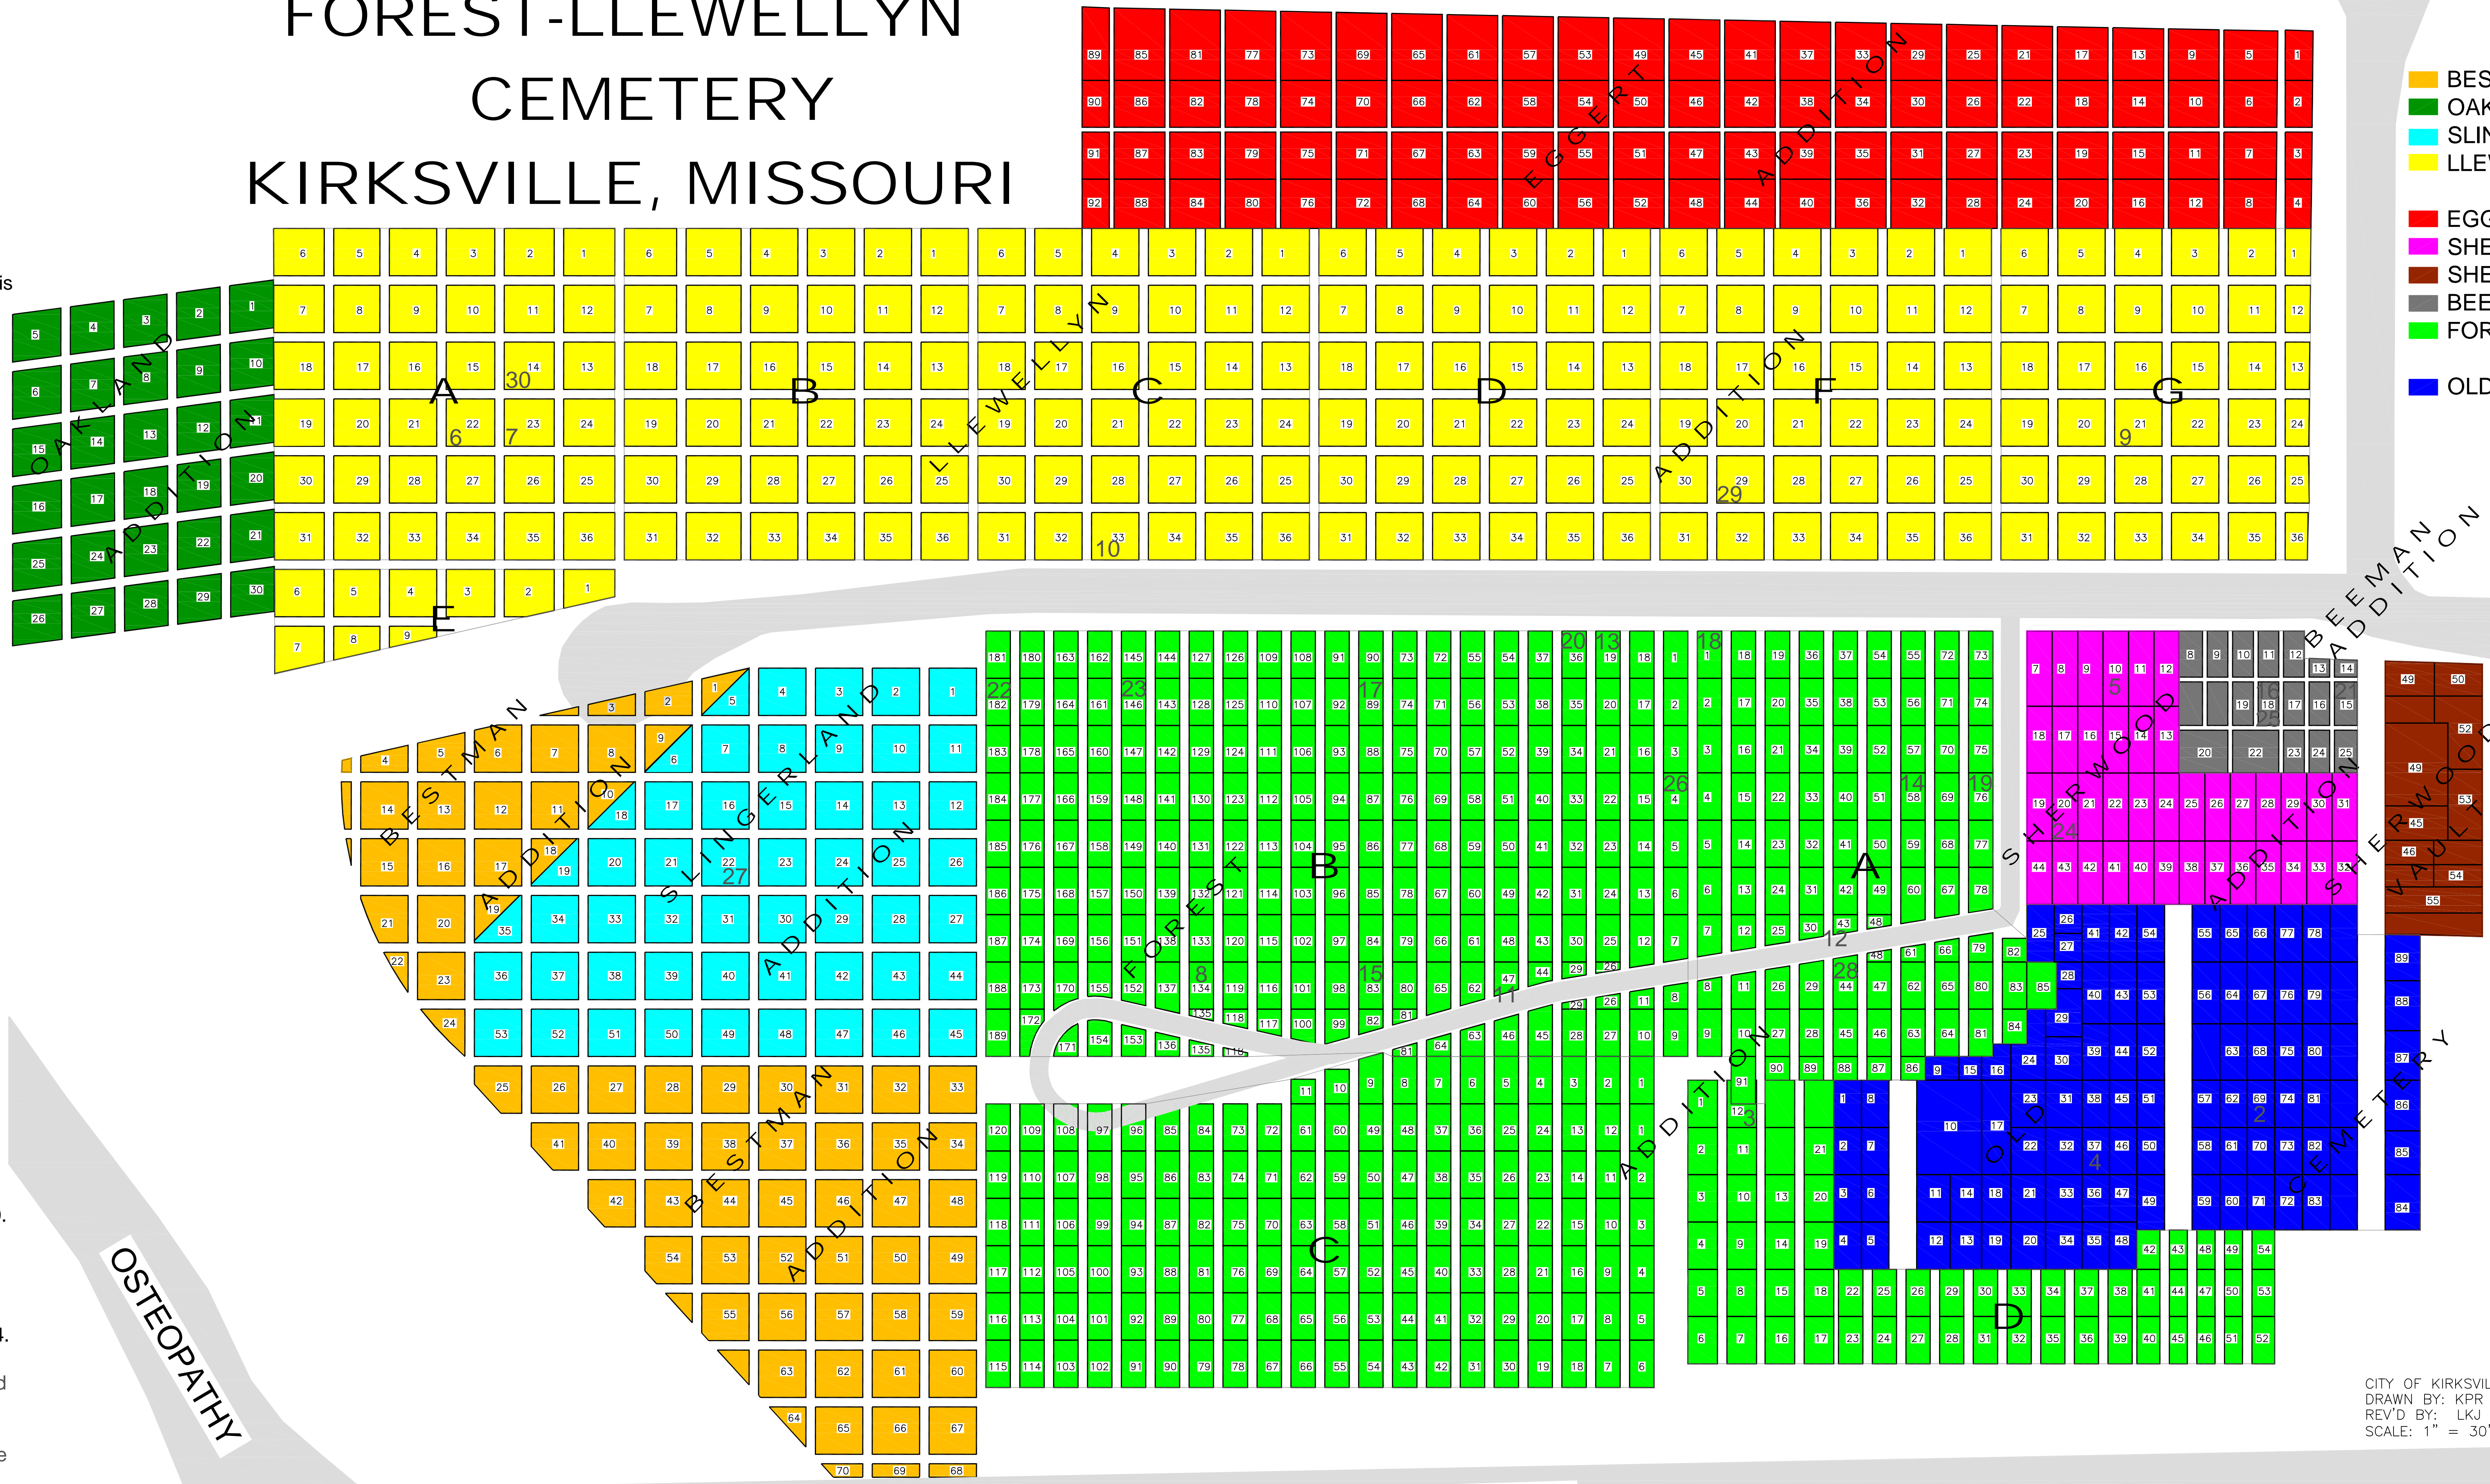

MISSOURI ST.

WASHINGTON ST.

- BESTMAN ADDITION
- SLINGERLAND ADDITION
- LLEWELLYN ADDITION
A, B, C, D, E, F, G
- EGGERT ADDITION
- SHERWOOD ADDITION
- SHERWOOD VAULT
- BEEMAN ADDITION
- FOREST ADDITION
A, B, C, D
- OLD CEMETERY

MAIN
ENTRANCE

CITY OF KIRKSVILLE, ENGINEERING DEPARTMENT
DRAWN BY: KPR DATE: MARCH, 2009
REV'D BY: LKJ DATE: DECEMBER 2013
SCALE: 1" = 30'